

**Calaveras County Water District
Copper Cove, California
Bidding Documents
Lake Tulloch Intertie Project
ADDENDUM NO. 2
Issued July 1, 2026
Bid Date: July 9, 2026 at 2pm**

The Drawings and Project Manual including Specifications are modified as follows. Addendum No. 2 forms a part of the Contract Documents and modifies the original documents dated May 2026.

This Addendum consists of three (3) pages and two (2) attachments:

- Attachment A: Update Plan Sheets
- Attachment B: Updated Bid Form

Bidder's Note: Bidder shall acknowledge receipt and examination of this addendum on the Bid form and attach a signed copy to the Bid, both as required by the Sealed Proposal.

Contract Documents – Specifications Change:

- 1) Replace Section 00 04 10: Bid Form with Bid Form provided in Attachment B
- 2) Revise Section 33 14 19: Valves and Hydrants, as follows:

“B. Materials:

1. Body: Ductile Iron.
2. Cover: Ductile Iron.
3. Seat: Buna N.
4. Float Lever: ~~Bronze~~, **Stainless Steel**.
5. Float: Stainless Steel.
6. Hardware: Stainless Steel.”

Responses to Bidder Questions:

Question #1: Please confirm the number of Air Release Valves (ARV total qty listed is 6) per Bid Item 11, as we have counted a total of 8 at the following locations:

**STA 100+05.61
STA 112+06.29
STA 125+69.75
STA 156+55.97
STA 170+19.22
STA 204+37.65**

**STA 401+43.87
STA 407+64.31**

Response #1: The correct quantity of Air Release Valves is eight (8). An updated Bid Form reflecting this quantity is included as Attachment B to this addendum.

Question #2: Most of the listed Air and Vacuum Relief Valve Manufacturers use 316SS as the standard material for a float lever. Please add this to the standard materials. It is superior to bronze.

Response #2: Stainless steel is acceptable as a standard material for the Air Release Valve float lever arm. Specification Section 33 14 10, Paragraph 2.03.B.4 has been revised accordingly.

Question #3: Specification Section 33 14 19 Division 2.03 - A.4 states "1 and 2 inch inlet" Detail drawing 6 - C18 shows a 3" flanged Air/Vac. Please provide clarification on the size of the inlet that is required for this system

Response #3: Air Release Valves installed under this project shall be 2-inch. The standard detail shown on Sheet C18 currently identifies Item No. 5 as a 4-inch by 3-inch reducing 90-degree elbow. Item No. 5 shall be revised to a 4-inch by 2-inch reducing 90-degree elbow to accommodate the required 2-inch Air Release Valve. Detail 6 on Sheet C18 has been revised to include a clarifying note, as shown in Attachment A.

Question #4: Please provide clarification on the required thickness of the asphalt for the trench restoration and T-Cut sections, including any required asphalt base for the T-Cut areas.

Response #4: Trench restoration shall be performed in accordance with the Calaveras County Standard Trench Restoration Detail. Per the standard detail, the street structural section shall be restored to match existing field conditions. The County has further directed that the replacement asphalt concrete (AC) section shall be a minimum of 1 inch thicker than the existing asphalt section. Because existing asphalt thickness may vary throughout the project limits, an assumed AC thickness of 6 inches was used to calculate the quantity for Bid Item No. 5, Roadway Pavement Replacement (Trench) to be conservative.

By: _____

Kevin Williams
District Engineer, Calaveras County Water District

ACKNOWLEDGMENT BY BIDDER,


By: _____

Title: _____


(NOTE – Bidders are hereby advised that they also need to sign their acknowledgement of this Addendum on their Bid Schedule.)

-END OF ADDENDUM NO. 2


ATTACHMENT A

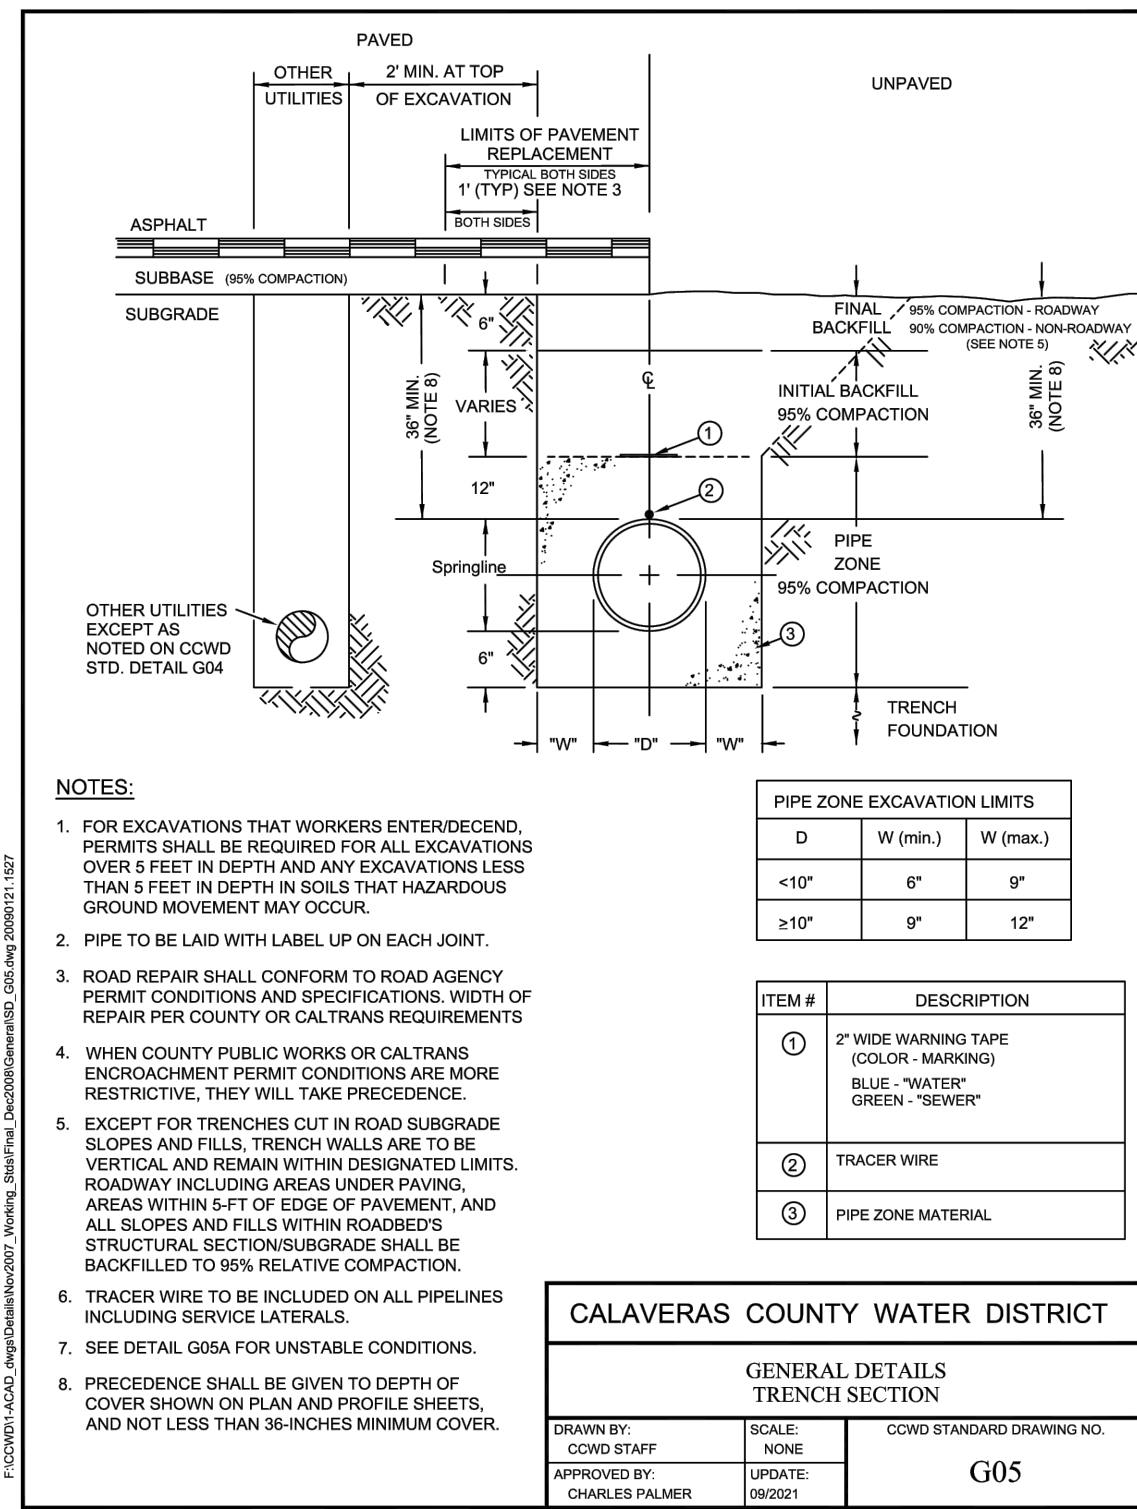



TRENCH SECTIONS **1**
NTS

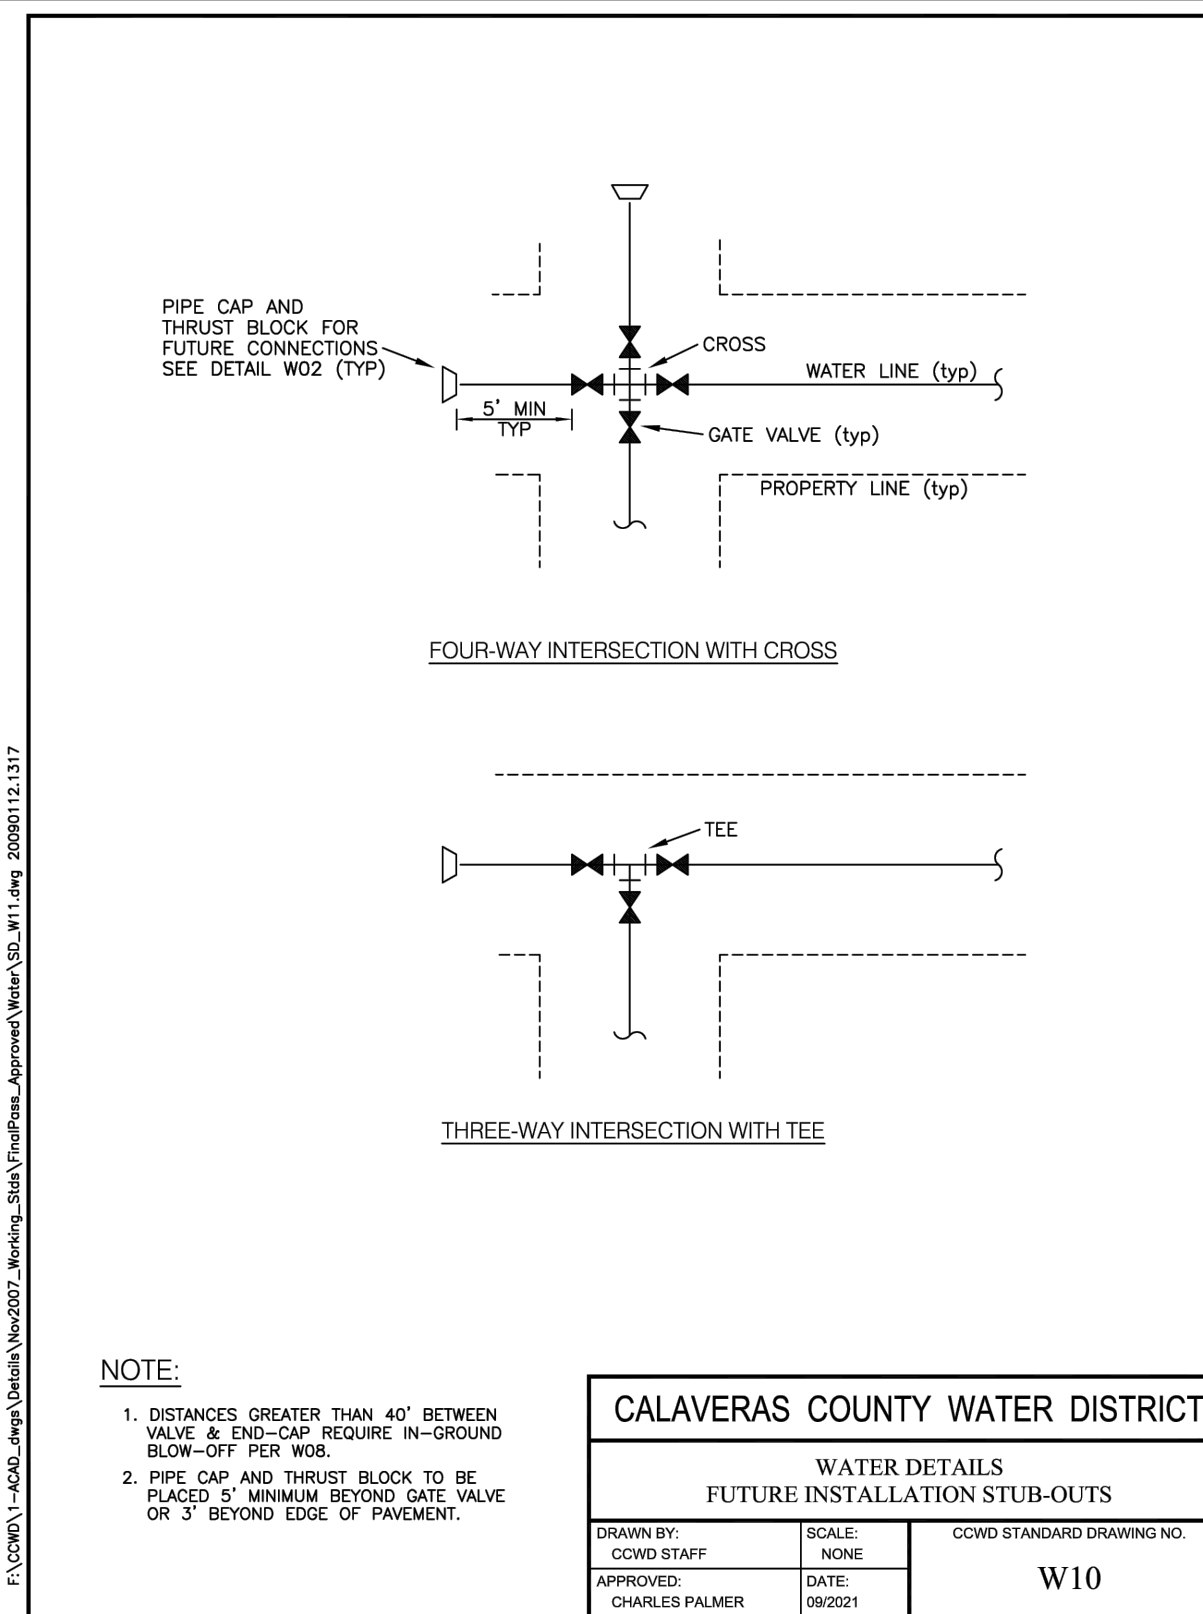


FUTURE INSTALLATION STUB-OUTS **2**
NTS

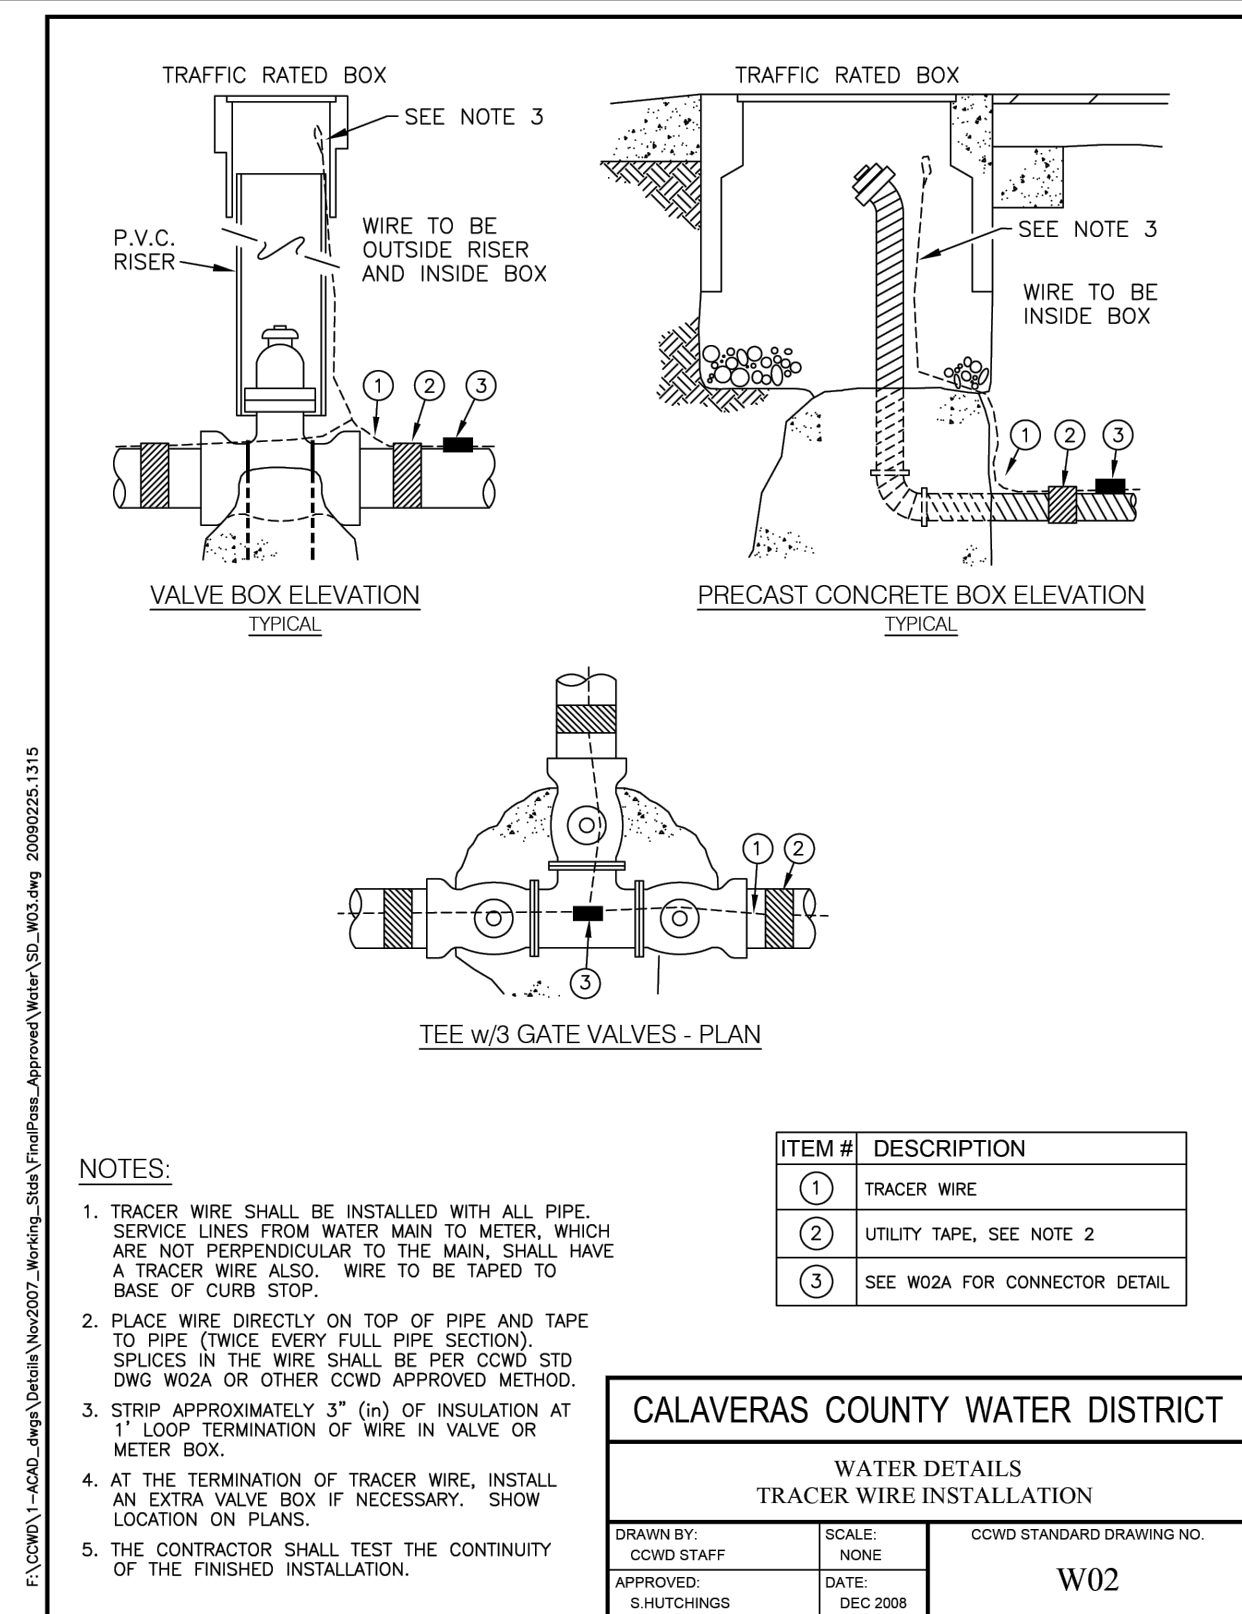

LOCATING WIRE INSTALLATION **3**
NTS

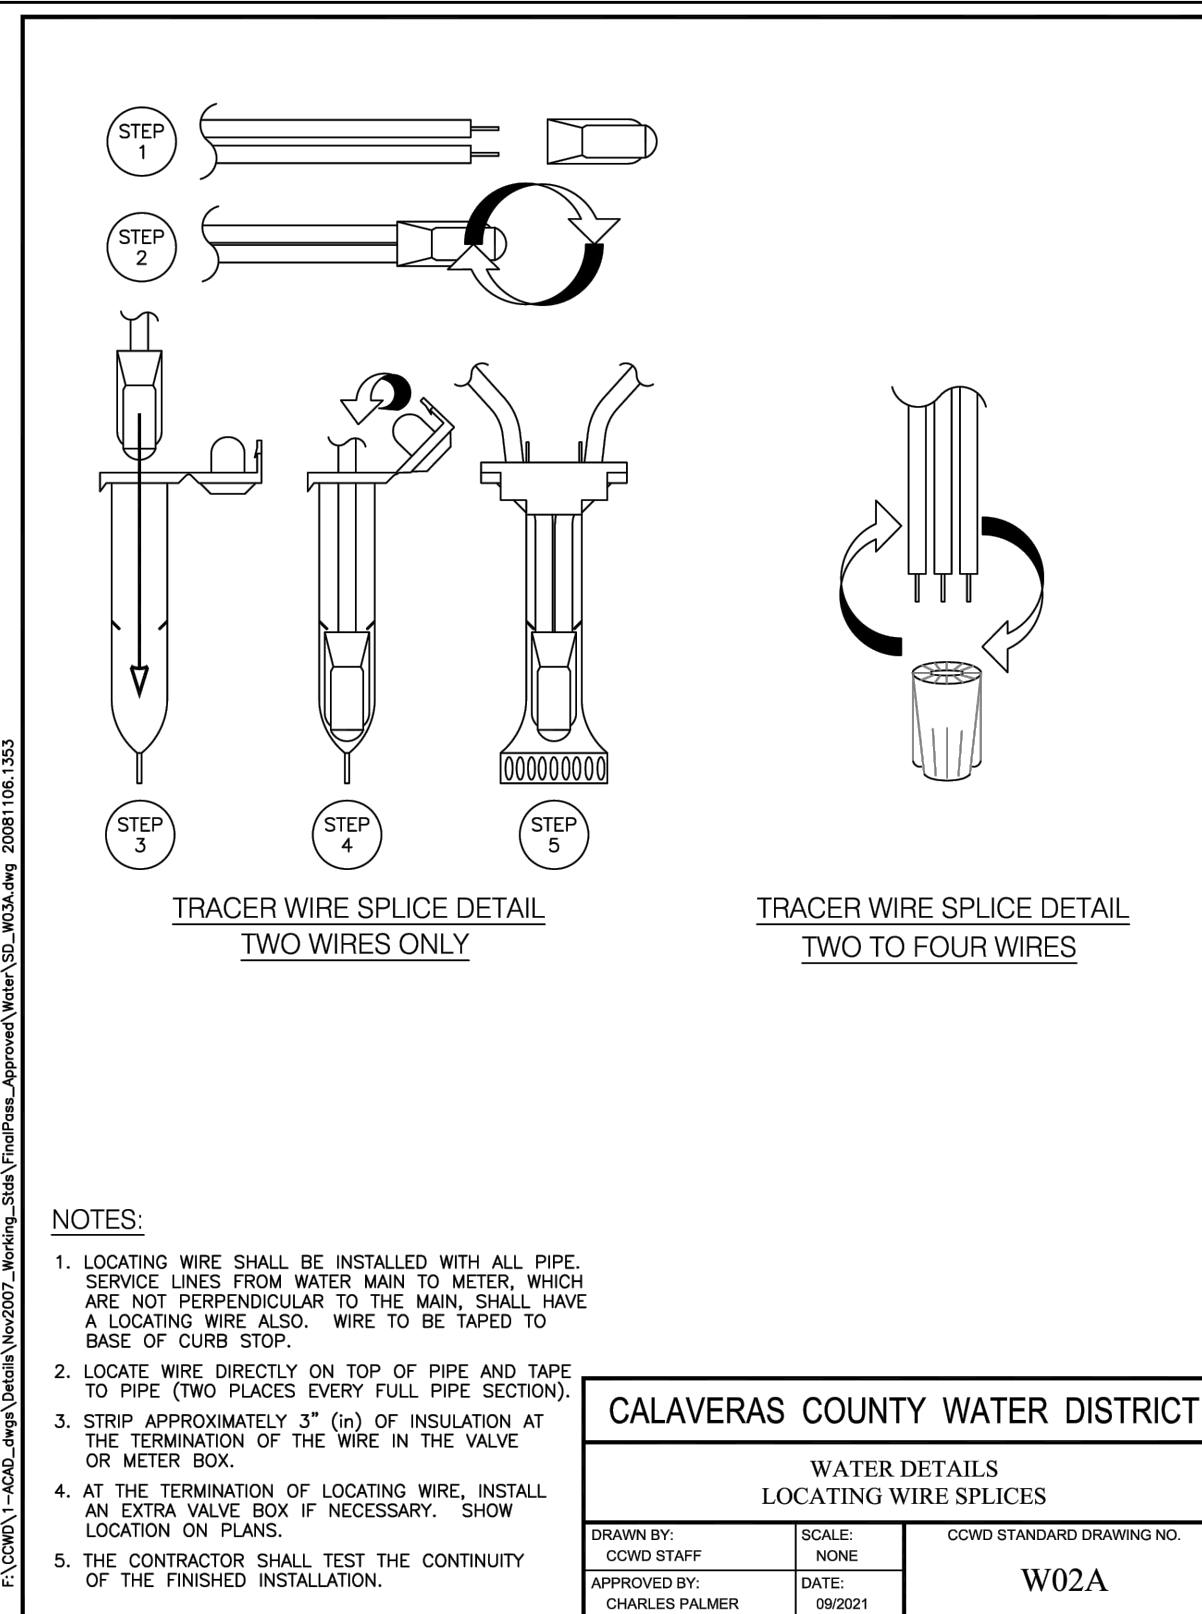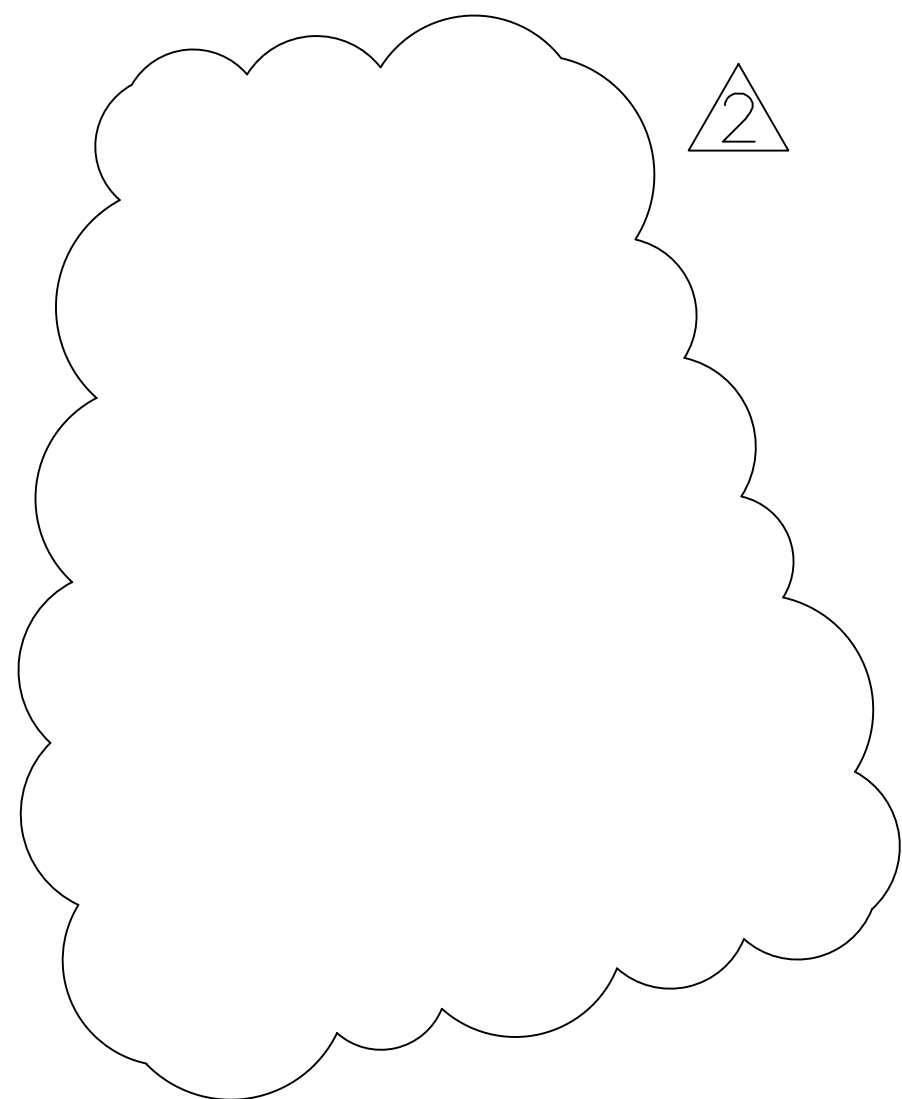

LOCATING WIRE SPLICES **5**
NTS

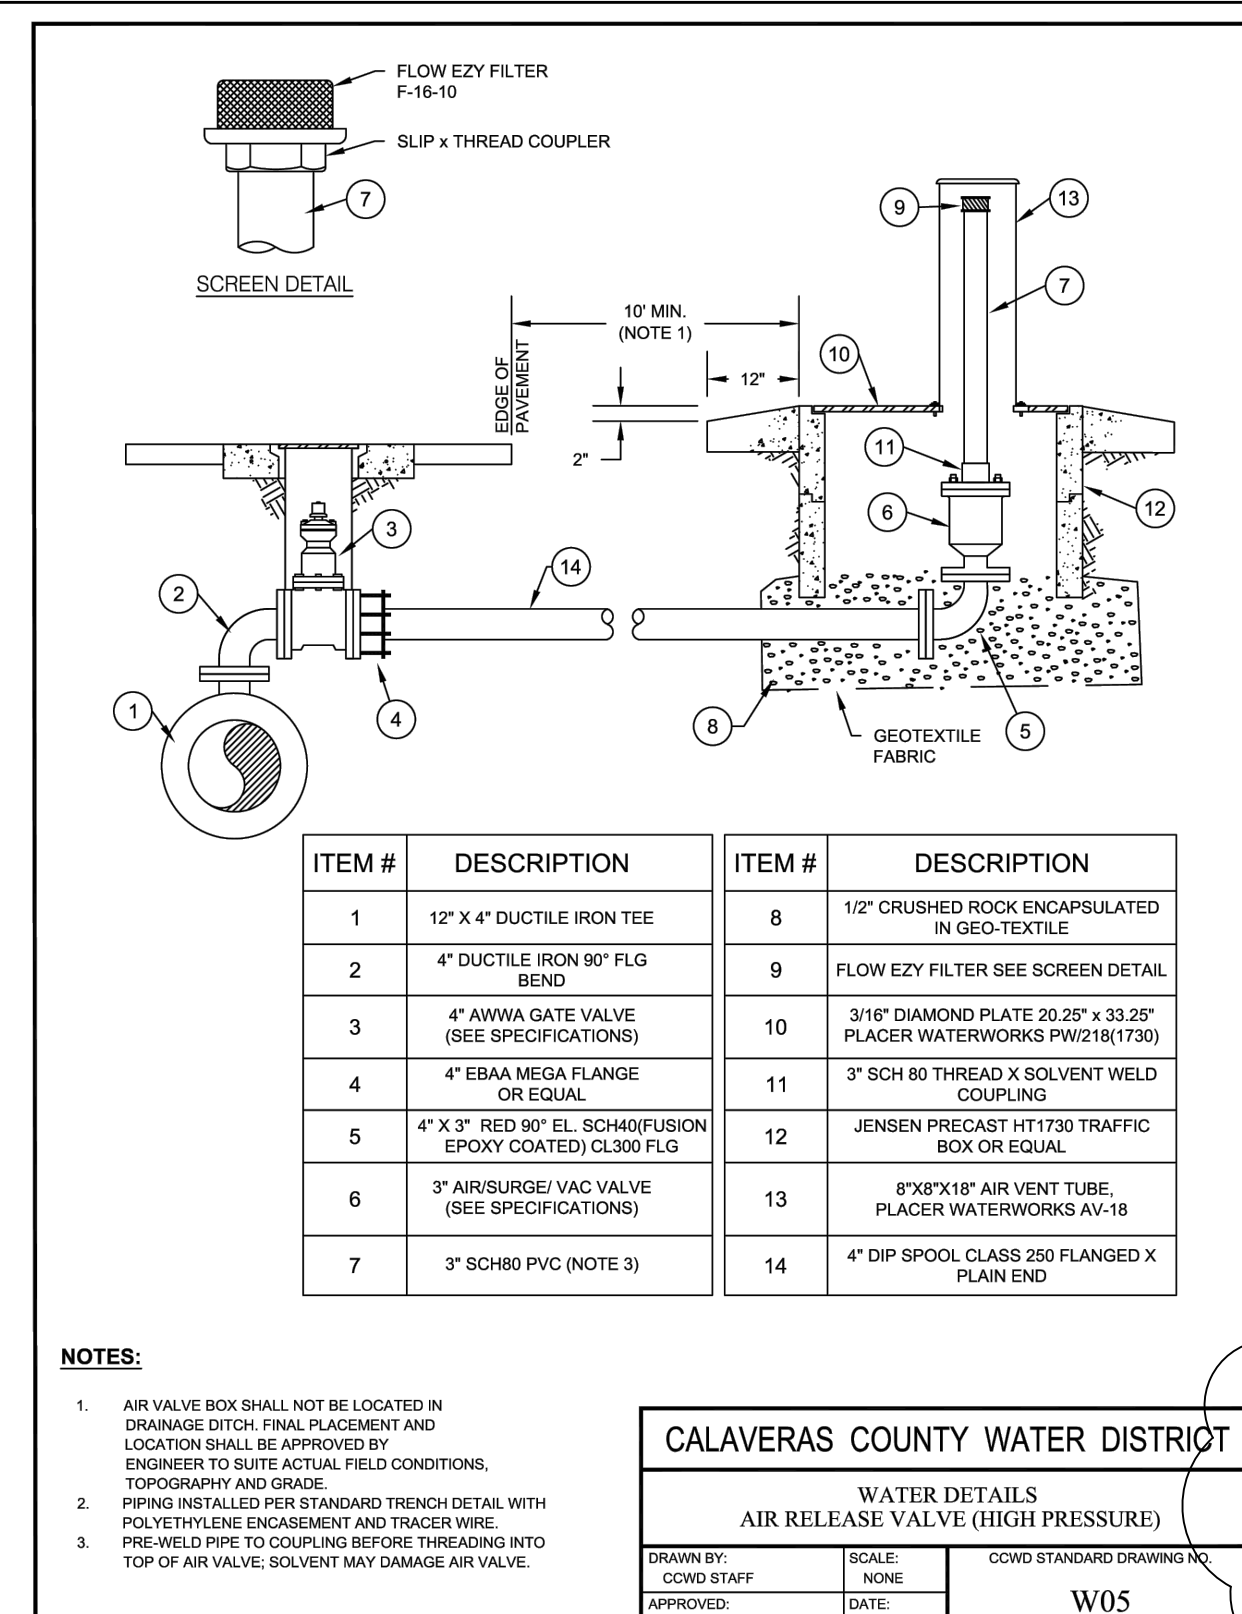

AIR RELEASE VALVE (HIGH PRESSURE) **6**
NTS

PROJECT NOTES:

- FOR THIS PROJECT, ITEM #5 SHALL BE REPLACED WITH A 4"X2" REDUCING 90° ELBOW TO ACCOMMODATE A 2" ARV.

P:\CCWD\Copper Cove Water System Improvements\05 Drawings\5.1 CAD\Lake Tulloch Inter-tie\Details.dwg 6-30-26 10:00:54 AM gaevedo

REV	DATE	BY	DESCRIPTION
2	7/01/26	ADA	ADDENDUM 2 - DETAIL 4 REMOVED, DETAIL 6 NOTE ADDED

SCALE:	WARNING
DATE:	IF THIS BAR DOES NOT MEASURE 1" THEN DRAWING IS NOT TO SCALE.
MAY 2026	

DESIGNED	AAS
DRAWN	LAH/DG
CHECKED	KBB



120 TOMA COURT,
SAN ANDREAS, CALIFORNIA 95249
PHONE (209) 754-3543



80 Blue Ravine Rd. Suite 280
Folsom, CA 95630
PH. 916-608-2212



COPPER COVE WATER SYSTEM IMPROVEMENTS PROJECT - LAKE TULLOCH INTER-TIE

STANDARD DETAILS I


BID SET

FIGURE


C18

SHEET 20 OF 29

- NOTES:
1. WATER MAINS SHALL BE INSTALLED WITH A MINIMUM 36 INCHES OF COVER.
 2. ALL JOINTS AND FITTINGS SHALL BE FULLY RESTRAINED.
 3. CONTRACTOR SHALL BE RESPONSIBLE FOR POTHOLING EXISTING UTILITIES PRIOR TO INSTALLATION OF NEW WATER MAINS AND APPURTENANCES. PRIOR TO PROCEEDING WITH TIE-INS TO EXISTING WATER MAINS, CONTRACTOR SHALL LOCATE EXISTING UTILITIES TO CONFIRM REQUIRED SEPARATION DISTANCES ARE ACHIEVABLE.

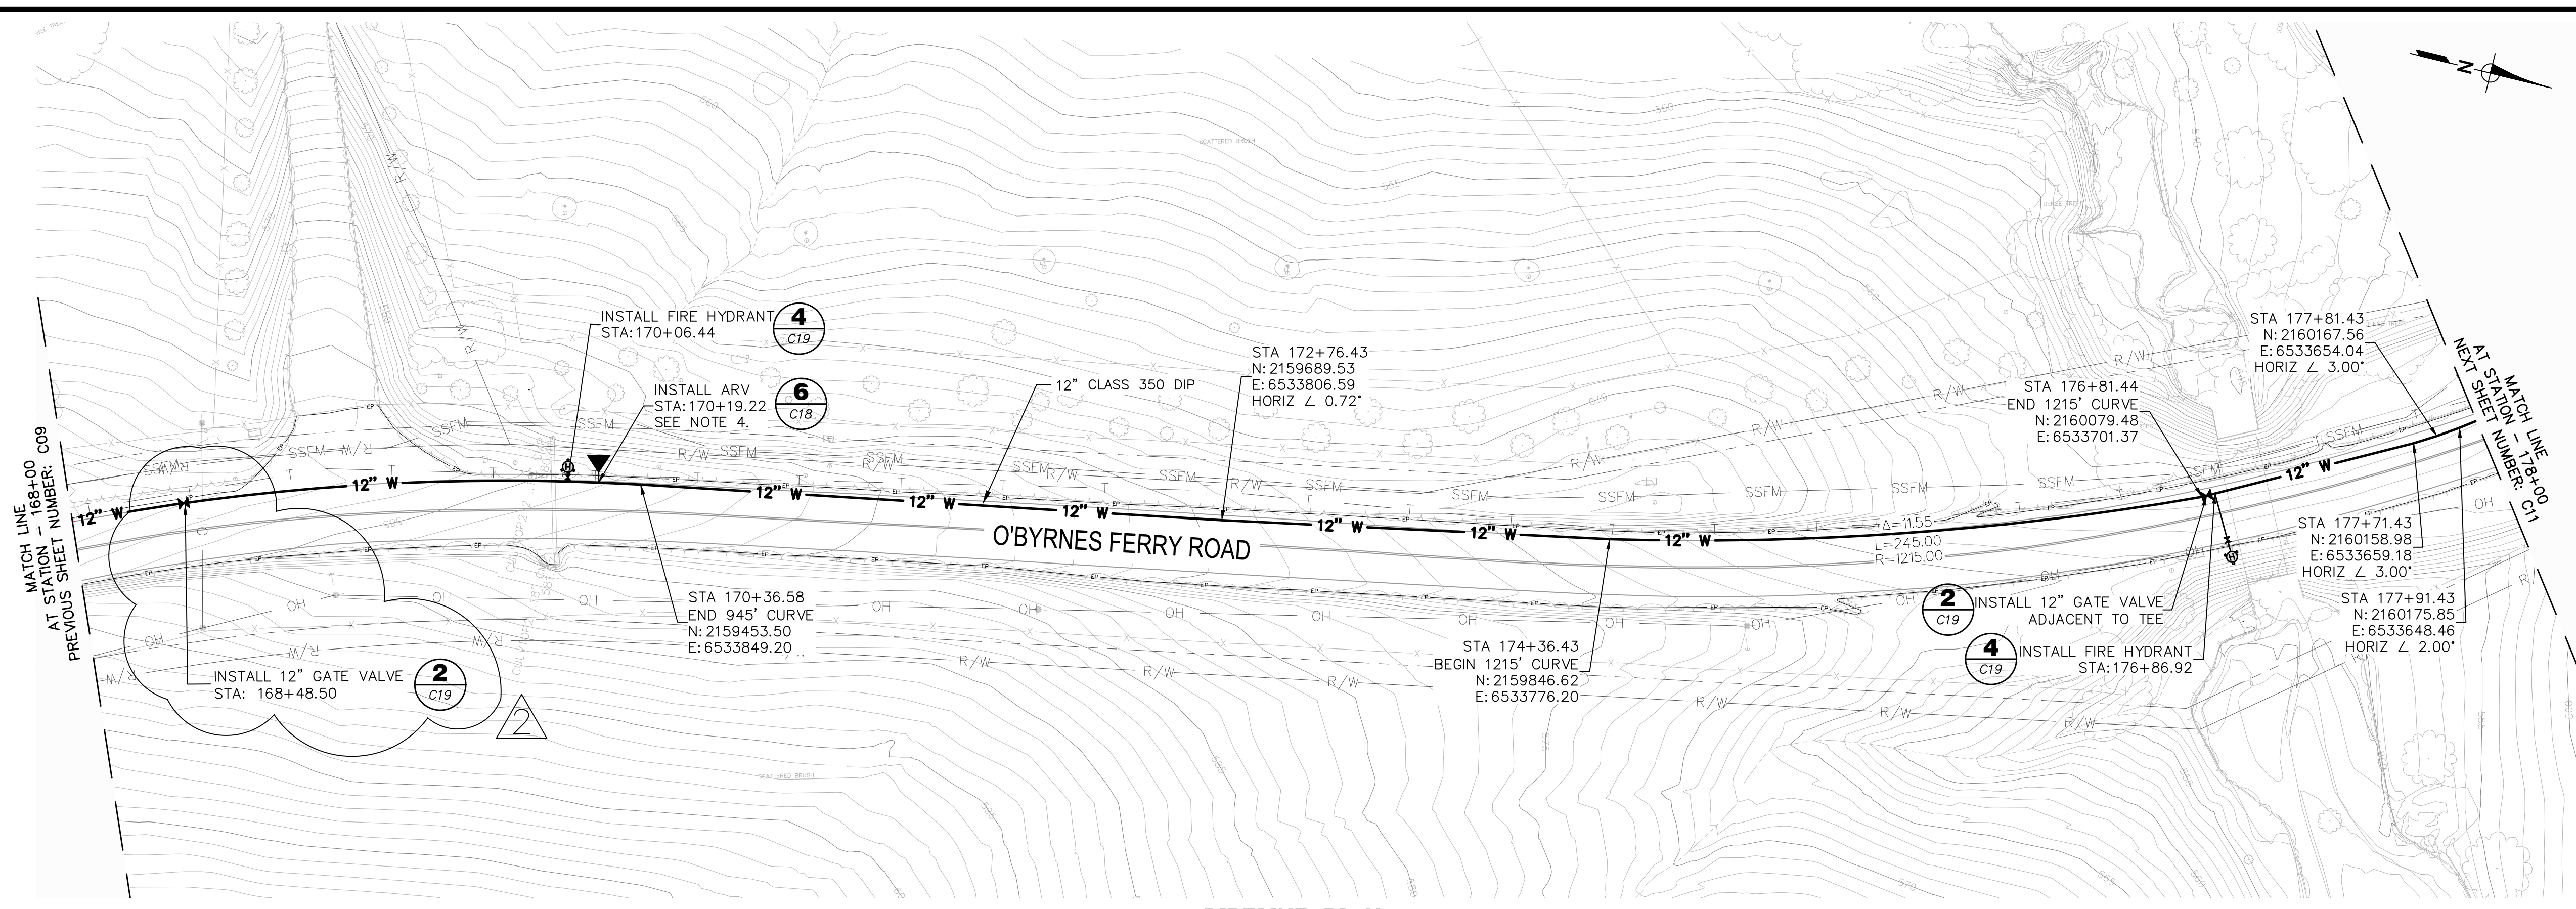

PIPELINE PLAN
HORIZ SCALE: 1"=40'

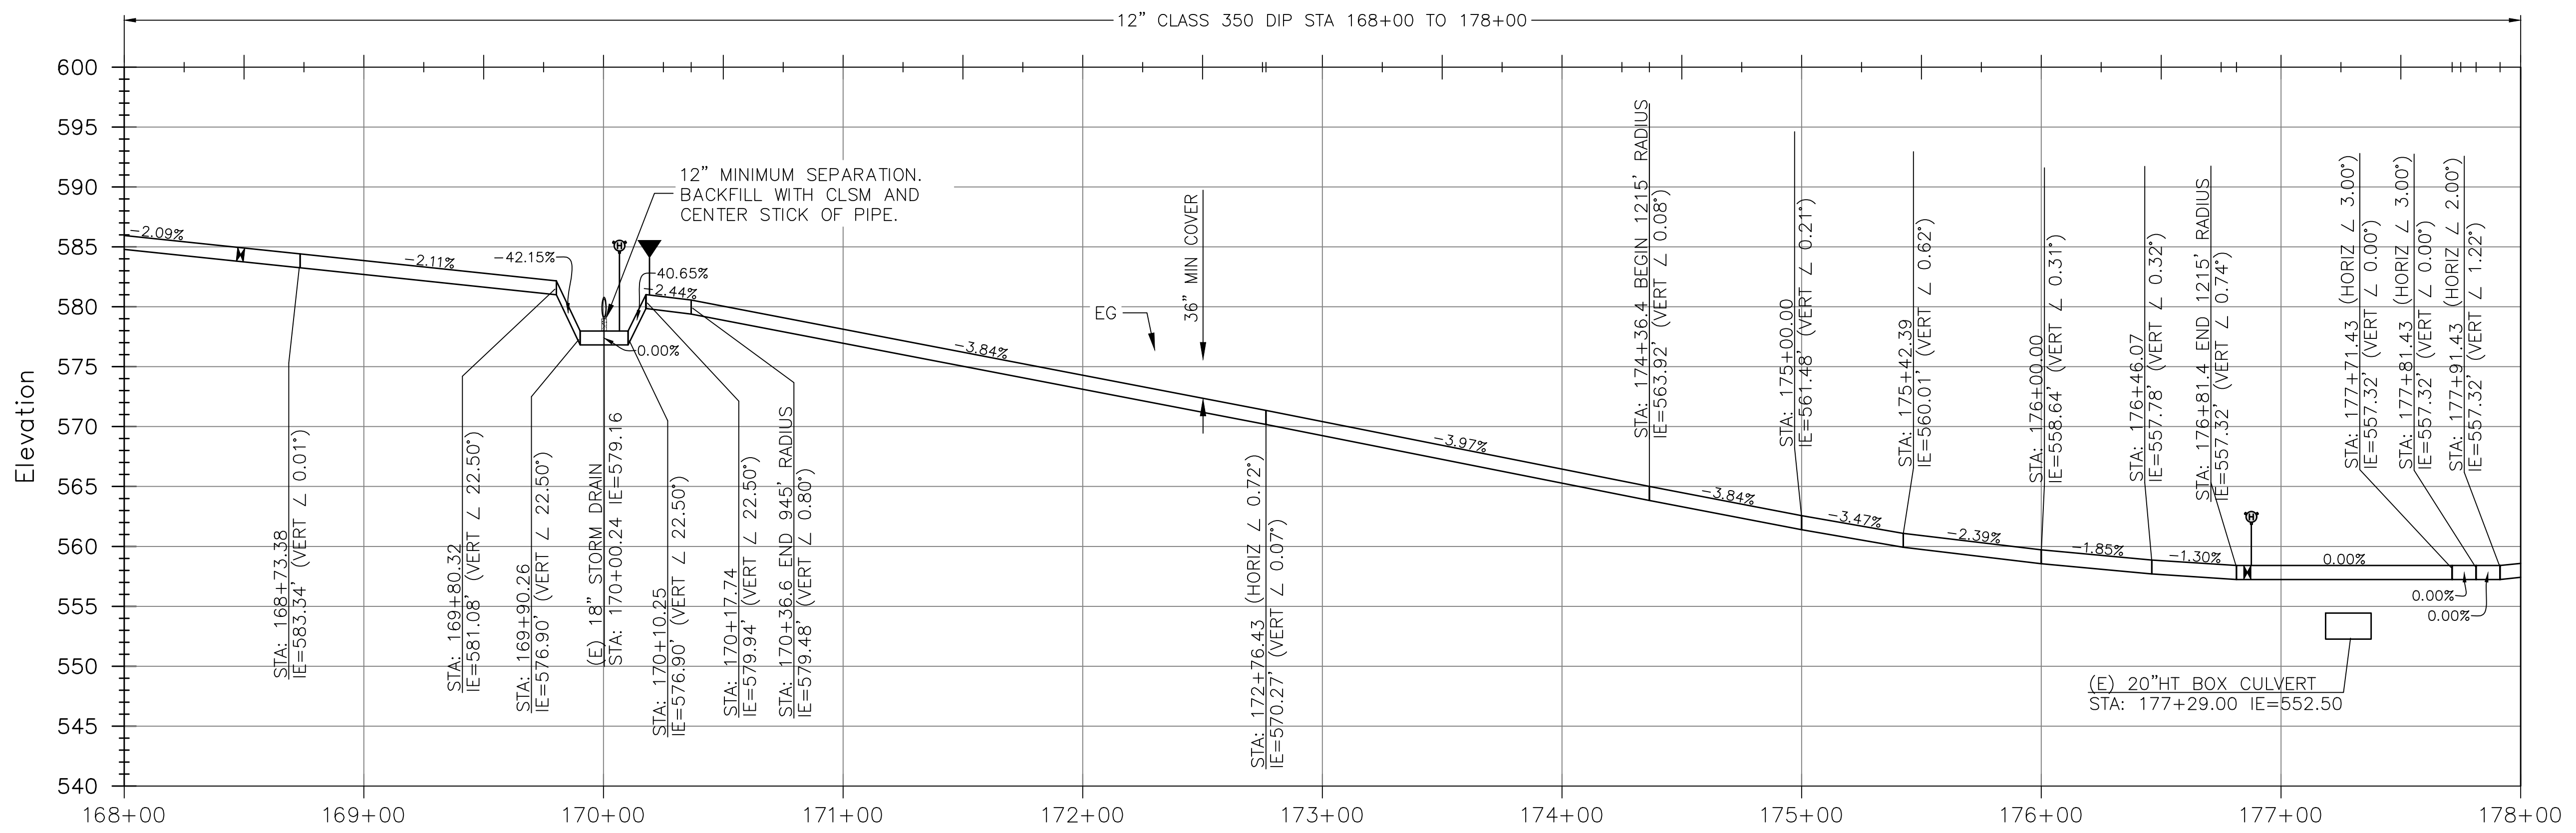

PIPELINE PROFILE
HORIZ SCALE: 1"=40' | VERT SCALE: 1"=8'

P:\CCWD\Copper Cove Water System Improvements\05 Drawings\5.1 CAD\Lake Tulloch InterTie\Tulloch InterTie (2023) - Civil.dwg 6-30-26 09:35:39 AM azevedo

REV	DATE	BY	DESCRIPTION
2	7/01/26	ADA	ADDENDUM 2 - GATE VALVE ADDED TO PLAN VIEW

SCALE:	WARNING
AS NOTED	0 1/2 1
DATE:	IF THIS BAR DOES NOT MEASURE 1" THEN DRAWING IS NOT TO SCALE.
MAY 2026	

DESIGNED	AAS
DRAWN	LAH/DG
CHECKED	KBB



120 TOMA COURT,
SAN ANDREAS, CALIFORNIA 95249
PHONE (209) 754-3543



80 Blue Ravine Rd. Suite 280
Folsom, CA 95630



PH. 916-608-2212

COPPER COVE WATER SYSTEM IMPROVEMENTS PROJECT - LAKE TULLOCH INTER-TIE

PLAN AND PROFILE
STA 168+00 TO 178+00

BID SET

FIGURE

C10

SHEET 12 OF 29

ATTACHMENT B

**SECTION 00 04 10
BID FORM**

TABLE OF ARTICLES

- Article 1 - Bid Recipient
- Article 2 - Bidder's Acknowledgments
- Article 3 - Bidder's Representations
- Article 4 - Bidder's Certification
- Article 5 - Basis of Bid
- Article 6 - Time of Completion
- Article 7 - Attachments to Bid
- Article 8 - Defined Terms
- Article 9 - Bid Submittal
- Bid Schedule
- Descriptions of Bid Items

ARTICLE 1- BID RECIPIENT

- 1.01 **This Bid is submitted to: Calaveras County Water District at the main office located at 120 Toma Court, San Andreas, California 95249, no later than 2pm local time, July 9th, 2026.**
- 1.02 The undersigned Bidder proposes and agrees, if this Bid is accepted, to enter into an Agreement with Owner in the form included in the Bidding Documents to perform all Work as specified or indicated in the Bidding Documents for the prices and within the times indicated in this Bid and in accordance with the other terms and conditions of the Bidding Documents.

ARTICLE 2- BIDDER'S ACKNOWLEDGEMENTS

- 2.01 Bidder accepts all of the terms and conditions of the Instructions to Bidders, including without limitation those dealing with the disposition of Bid security. This Bid will remain subject to acceptance for 90 days after the Bid opening, or for such longer period of time that Bidder may agree to in writing upon request of Owner.

ARTICLE 3- BIDDER'S REPRESENTATIONS

- 3.01 In submitting this Bid, Bidder represents that:
 - A. Bidder has examined and carefully studied the Bidding Documents, the other related data identified in the Bidding Documents, and the following Addenda, receipt of which is hereby acknowledged.

Addendum No.	Addendum Date
_____	_____
_____	_____
_____	_____
_____	_____

- B. Bidder has visited the Site and become familiar with and is satisfied as to the general, local and Site conditions that may affect cost, progress, and performance of the Work.
- C. Bidder is familiar with and is satisfied as to all Federal, State and local Laws and Regulations that may affect cost, progress and performance of the Work.

- D. Bidder has carefully studied all: (1) reports of explorations and tests of subsurface conditions at or contiguous to the Site and all drawings of physical conditions in or relating to existing surface or subsurface structures at or contiguous to the Site (except Underground Facilities) which have been identified in SC-4.02, and (2) reports and drawings of Hazardous Environmental Conditions, if any, at the Site that have been identified in SC-4.06 as containing reliable “technical data.”
- E. Bidder has considered the information known to Bidder; information commonly known to contractors doing business in the locality of the Site; information and observations obtained from visits to the Site; the Bidding Documents; and the Site-related reports and drawings identified in the Bidding Documents, with respect to the effect of such information, observations, and documents on (1) the cost, progress, and performance of the Work; (2) the means, methods, techniques, sequences, and procedures of construction to be employed by Bidder, including applying the specific means, methods, techniques, sequences, and procedures of construction expressly required by the Bidding Documents; and (3) Bidder’s safety precautions and programs.
- F. Based on the information and observations referred to in Paragraph 3.01.E above, Bidder does not consider that any further examinations, explorations, tests, studies, or data are necessary for the determination of this Bid for performance of the Work at the price(s) bid and within the times and in accordance with the other terms and conditions of the Bidding Documents.
- G. Bidder is aware of the general nature of the Work to be performed by Owner and others at the Site that relates to the Work as indicated in the Bidding Documents.
- H. Bidder has given Engineer written notice of all conflicts, errors, ambiguities, or discrepancies that Bidder has discovered in the Bidding Documents, and the written resolution thereof by Engineer is acceptable to Bidder.
- I. The Bidding Documents are generally sufficient to indicate and convey understanding of all terms and conditions for the performance of the Work for which this Bid is submitted.
- J. Bidder will submit written evidence of its authority to do business in the State or other jurisdiction where the Project is located not later than the date of its execution of the Agreement.

ARTICLE 4- BIDDER’S CERTIFICATION

4.01 Bidder further represents that:

- A. This Bid is genuine and not made in the interest of or on behalf of any undisclosed individual or entity and is not submitted in conformity with any agreement or rules of any group, association, organization or corporation;
- B. Bidder has not directly or indirectly induced or solicited any other Bidder to submit a false or sham Bid;
- C. Bidder has not solicited or induced any individual or entity to refrain from bidding; and
- D. Bidder has not engaged in corrupt, fraudulent, collusive, or coercive practices in competing for the Contract. For the purposes of this Paragraph 4.01.D:
 - 1. “Corrupt practice” means the offering, giving, receiving, or soliciting of anything of value likely to influence the action of a public official in the bidding process.
 - 2. “fraudulent practice” means an intentional misrepresentation of facts made to (a) to influence the bidding process to the detriment of Owner, (b) to establish bid prices at artificial non-competitive levels, or (c) to deprive Owner of the benefits of free and open competition;

3. “collusive practice” means a scheme or arrangement between two or more Bidders, with or without the knowledge of Owner, a purpose of which is to establish bid prices at artificial, non-competitive levels; and
4. “coercive practice” means harming or threatening to harm, directly or indirectly, persons or their property to influence their participation in the bidding process or affect the execution of the Contract.

ARTICLE 5- BASIS OF BID

- 5.01 Bidder will complete the Work in accordance with the Contract Documents for the price(s) provided in the attached bid schedule (at the end of this section).
- 5.02 Unit Prices have been computed in accordance with Paragraph 11.03.B of the General Conditions
- 5.03 Bidder acknowledges that estimated quantities are not guaranteed, and are solely for the purpose of comparison of Bids, and final payment for all Unit Price Bid items will be based on actual quantities, determined as provided in the Contract Documents.
- 5.04 Bid Prices are for work that has been furnished and installed by the Contractor and is fully completed. The bid items as described and provided are for bidding and payment purposes and do not in any way limit the Contractor’s responsibility to perform all work that may be reasonably inferred from the plans, specifications and other bid documents to produce the intended result.
- 5.05 All specified cash allowances are included in the price(s) set forth above and have been computed in accordance with Paragraph 11.02 of the General Conditions.
- 5.06 If “additive” or “deductive” Bid Items are included in the Bid- clearly identify the method for applying the alternates and the basis for award of the contract.

ARTICLE 6- TIME OF COMPLETION

- 6.01 Bidder agrees that the Work will be substantially complete and will be completed and ready for final payment in accordance with Paragraph 14.07 of the General Conditions on or before the dates or within the number of calendar days indicated in the Agreement.
- 6.02 Bidder accepts the provisions of the Agreement as to liquidated damages.

ARTICLE 7- ATTACHMENTS TO THIS BID

- 7.01 The following documents are attached to and made a condition of this Bid:
 - A. Non-Collusion Affidavit (**Section 00420**);
 - B. Required Bid security in the form of a Bid Bond (**Section 00430**) or Certified Check;
 - C. List of Subcontractors (**Section 00470**);

ARTICLE 8- DEFINED TERMS

- 8.01 The terms used in this Bid with initial capital letters have the meanings stated in the Instructions to Bidders (Section 00200), General Conditions (Section 00700 and Supplementary Conditions (Section 00800).

ARTICLE 9- BID SUBMITTAL

9.01 This Bid is submitted by: _____

Bidder's Business address: _____

Phone: _____ Facsimile: _____

Submitted on _____, _____.

State Contractor License No. _____

DIR Registration No. _____

Employer's Tax ID No. _____

If Bidder is:

An Individual

Name (typed or printed): _____

By: _____
(Individual's signature)

Doing business as: _____

A Partnership

Partnership Name: _____ (SEAL)

By: _____
(Signature of general partner – attach evidence of authority to sign)

Name (typed or printed): _____

A Corporation

Corporation Name: _____ (SEAL)

State of Incorporation: _____

Type (General Business, Professional, Service, Limited Liability): _____

By: _____
(Signature – attach evidence of authority to sign)

Name (typed or printed): _____

Title: _____

Attest: _____
(Signature of Corporate Secretary)

Date of Qualification to do business is ____ \ ____ \ ____.

A Joint Venture

Name of Joint Venturer: _____

First Joint Venturer Name: _____ (SEAL)

By: _____
(Signature of first joint venture partner – attach evidence of authority to sign)

Name (typed or printed): _____

Title: _____

Second Joint Venturer Name: _____ (SEAL)

By: _____
(Signature of second joint venture partner – attach evidence of authority to sign)

Name (typed or printed): _____

Title: _____

(Each joint venturer must sign. The manner of signing for each individual, partnership, and corporation that is a party to the joint venture should be in the manner indicated above.)

BID SCHEDULE

ITEM	DESCRIPTION	UNIT	QTY	UNIT PRICE	BID PRICE
1	Mobilization/Demobilization	LS	1	\$	\$
2	Worker Protection and Safety/Shoring	LS	1	\$	\$
3	Implementation of SWPPP	LS	1	\$	\$
4	Traffic Control	LS	1	\$	\$
5	Roadway Pavement Replacement (Trench)	TON	2,610	\$	\$
6	Microsurfacing (Full Road Width)	SF	430,400	\$	\$
7	Pavement Striping and Markings	LS	1	\$	\$
8	12" Ductile Iron Pipe (Includes Excavation & Backfill)	LF	12,700	\$	\$
9	12" Gate Valves	EA	29	\$	\$
10	10" Gate Valves	EA	1	\$	\$
11	Fire Hydrants	EA	16	\$	\$
12	Air/Vac Valves	EA	8	\$	\$
13	Pressure Reducing Station	LS	1	\$	\$

**TOTAL BID AMOUNT ALL ITEMS (1 to 13)
(NUMERICAL)**

\$

DOLLARS

TOTAL BID AMOUNT (WRITTEN)

DESCRIPTIONS OF BID ITEMS

Note: Bid items listed herein for bidding and payment purposes do not limit Contractor's responsibility to perform all work required under this contract, on drawings, in specifications, or reasonably inferred or interpreted to be necessary to complete the work. All bid items will have 5% retention in the progress payment held for final payment.

BID ITEM NO. 1 – MOBILIZATION / DEMOBILIZATION

1. The work under this bid item shall include all contract administration, project mobilization, site development activities and demobilization as required to conduct and complete the Work, as identified in the Contract Documents. The total amount shall not exceed five percent (5%) of Total Base Bid Price as provided in the Bid Schedule. Item shall include, but not be limited to, the following:
 - a. Insurance premiums, bonds, permitting fees, security fencing, utilities, potholing and other facilities at the jobsite, Contractor's overhead, and costs inclusive of administering the Contract, management and quality control procedures, and coordination as required to construct and complete the Project.
 - b. Supply, transportation, and/or movement of personnel, equipment, supplies and incidentals to the work site. Equipment and major materials listed in Contractor's proposal shall be staged on site in the types and quantities shown. Additional shipments of material or transportation of equipment, if required, shall be approved in writing by District in advance.
 - c. Cleaning of equipment prior to mobilizing to the jobsite.
 - d. Identification and protection of existing facilities/utilities.
 - e. Site preparation of construction zone, vehicle/visitor parking, staging, laydown, and stockpile areas.
 - f. All project demobilization, site cleanup, and removal of personnel, equipment, materials, supplies, temporary facilities, site delineators, and construction waste from the jobsite to satisfy the requirements of 01 70 00 - Execution and Closeout Requirements and other applicable elements of the Contract Documents.
2. Work will be paid for on a lump sum basis. Contractor may apply for payment for up to one-third of the total lump sum amount with the Contractor's first application for payment and after completion of the Contractor's pre-construction obligations. Contractor may apply for payment for the remaining lump sum amount on a project percent complete basis.

BID ITEM NO. 2 – WORKER PROTECTION AND SAFETY/SHORING

1. The lump sum amount shall include detailed plan for worker safety and maintaining safety during construction complying with Labor Code Sections 6700-6708, all applicable safety orders and permits and protective equipment necessary for the protection and safety of all workers, other persons, equipment and facilities during the construction period as specified in the Contract Documents.
2. Contractor may apply for payment for this Bid Item on a percent complete basis as the items covered in Worker Protection and Safety/Shoring are being completed.

BID ITEM NO. 3 – IMPLEMENTATION OF STORM WATER POLLUTION PREVENTION PLAN

1. The lump sum amount shall include a Contractor provided Storm Water Pollution Prevention Plan (SWPPP) including installation of Best Management Practices (BMP's) for erosion control, spill control, and monitoring as required by the law.
2. Contractor may apply for payment for this Bid Item on a percent complete basis as the items covered in Implementation of SWPPP are being completed.

BID ITEM NO. 4 – TRAFFIC CONTROL

1. The work under this bid item shall include all temporary traffic control measures, devices, flaggers, and any other costs associated with the traffic control plan covered in the Drawings and Contract Specifications.
2. Work will be paid for on a percent complete basis as items performed are being completed.

BID ITEM NO. 5 – ROADWAY PAVEMENT REPLACEMENT (TRENCH)

1. The work under this bid item shall include all pavement restoration including compaction, material processing and importing, aggregate base and crushed rock bases, asphaltic concrete paving, and restoration of asphalt concrete curbs associated with replacing pavement in the roadway per Calaveras County Specifications. For bidding purposes, the pavement section shall be assumed to be 6 inches thick.
2. This item shall be paid in accordance with the actual tonnage that is delivered and installed. The unit price shall be full compensation per ton installed for the preparation and installation of these materials, and for all labor, equipment, tools, and incidentals to complete this item.

BID ITEM NO.6 – MICROSURFACING (FULL ROAD WIDTH)

1. The work under this bid item shall include the microsurfacing for the full width of the road associated with replacing pavement in the roadway per Calaveras County Specifications.
2. Work will be paid for on a square foot basis. The unit price shall be full compensation per square footage complete for the preparation and implementation or submittal of these materials and requirements, and for furnishing and installing all labor, equipment, materials, tools, and incidentals to complete this item.

BID ITEM NO.7 – PAVEMENT STRIPING AND MARKINGS

1. The work under this bid item shall include all pavement striping and markings, including removal of existing striping and markings, layout, and installation of new striping and pavement markings in accordance with the plans and Calaveras County Specifications.
2. This item shall be paid for on a lump sum basis. The lump sum price shall be full compensation for all labor, materials, equipment, tools, and incidentals required to complete this item.

BID ITEM NO.8 – 12” CLASS 350 DUCTILE IRON PIPE (INCLUDES EXCAVATION & BACKFILL)

1. The work under this bid item shall include furnishing and installing 12,700 LF of 12” Class 350 Ductile Iron Pipe including all restrained 12” fittings, joints, taps, tracer wire, excavation, trenching, backfill and compaction and ties to the existing system as shown and specified in the Contract Documents.
2. Work will be paid for on a linear foot basis. The unit price shall be full compensation per linear footage complete for the preparation and implementation or submittal of these materials and requirements, and for furnishing and installing all labor, equipment, materials, tools, and incidentals to complete this item.

BID ITEM NO.9 – 12” GATE VALVES

1. The work under this bid item shall include the furnishing and installation of 12” gate valves as shown on the Contract Documents.
2. Work will be paid for by each gate valve installed.

BID ITEM NO.10 – 10” GATE VALVES

1. The work under this bid item shall include the furnishing and installation of 10” gate valves as shown on the Contract Documents.
2. Work will be paid for by each gate valve installed.

BID ITEM NO.11 – FIRE HYDRANTS

1. The work under this bid item shall include furnishing and installation of fire hydrants including all valves, taps, joints, fittings, excavation, trenching, backfill and compaction as shown on the Contract Documents. This bid item shall also include the hauling and disposal of removed items.
2. Work will be paid for by each fire hydrant installed.

BID ITEM NO.12 – AIR/VAC VALVES

1. The work under this bid item shall include furnishing and installation of combination air and vacuum valves including all enclosures, valves, taps, joints, fittings, slurry if applicable, excavation, trenching, backfill and compaction as shown on the Contract Documents.
2. Work will be paid for by each combination air and vacuum valve installed.

BID ITEM NO.13 – PRESSURE REDUCING STATION

1. The work under this bid item shall include the furnishing and installation of a preassembled pressure-reducing station by a single manufacturer specializing in engineered piping systems, including the precast vault and hatch and all associated piping, appurtenances, and accessories, as shown on the Contract Documents, including but not limited to all spool pieces, fittings, pressure reducing valves, isolation valves, pressure gauges, flow meters, flow controls, Y strainer, and pipe supports.
2. Work will be paid for on a lump sum basis. The lump sum price shall be full compensation per percent complete for the preparation and implementation of these materials and requirements, and for furnishing and installing all labor, equipment, materials, tools, and incidentals to complete this item.